


M 1:5


Schauglas M 1:2,5

metallversch. Schauglas DN 150
Typ 19 Bio (Fabr. Metaglas)
aufgesetzt auf Sonderblockflansch DN 150
Ringwerkstoff 1.4462, Borosilikatglas n. DIN 7080

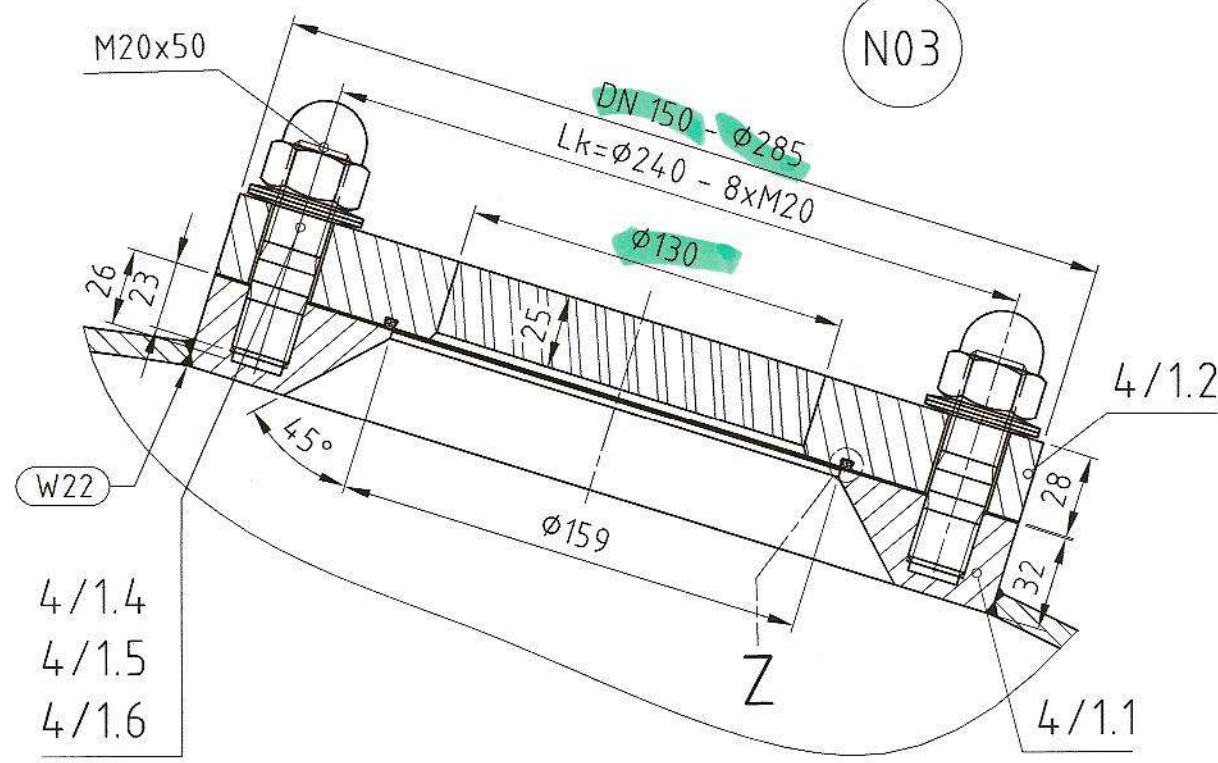

Lichtglas M 1:2,5


Metallverschmolzenes Schauglas DN 50
Typ 85 (Metaglas), aufgesetzt auf
Aseptik-Bundclump-Stutzen DN 50 - DIN 11864-3
inkl. Leuchte Type BKVLR D LED (Max Müller)
mit Taster, Gehäuse: 1.4301;
Anschluss: 24V, 2W, nicht EX geschützt
Ringwerkstoff 1.4462, Borosilikatglas n. DIN 7080

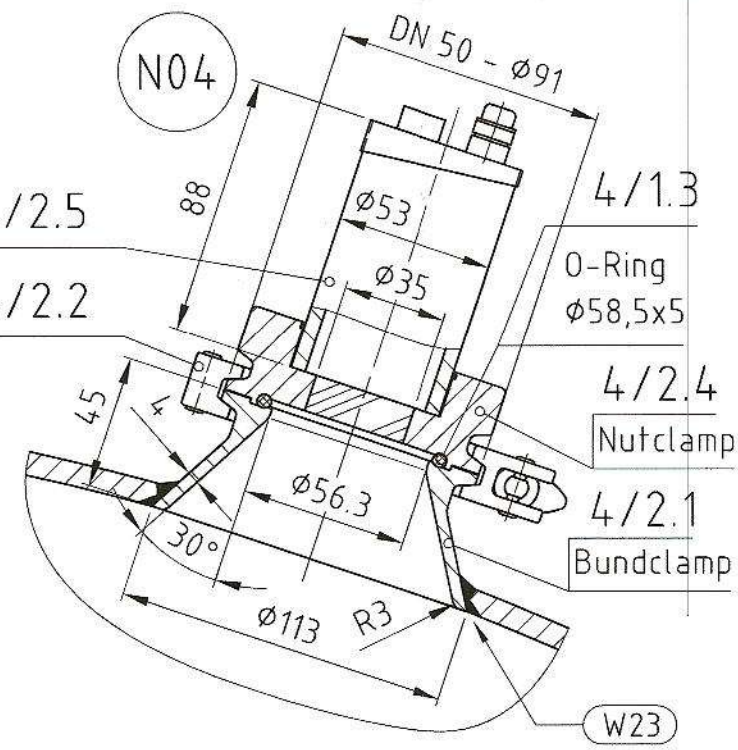


Berstscheibe M 1:2

Berstscheibe
nicht im Lieferumfang von Fa. Hinke


Distanzstück
im Lieferumfang von Fa. Hinke

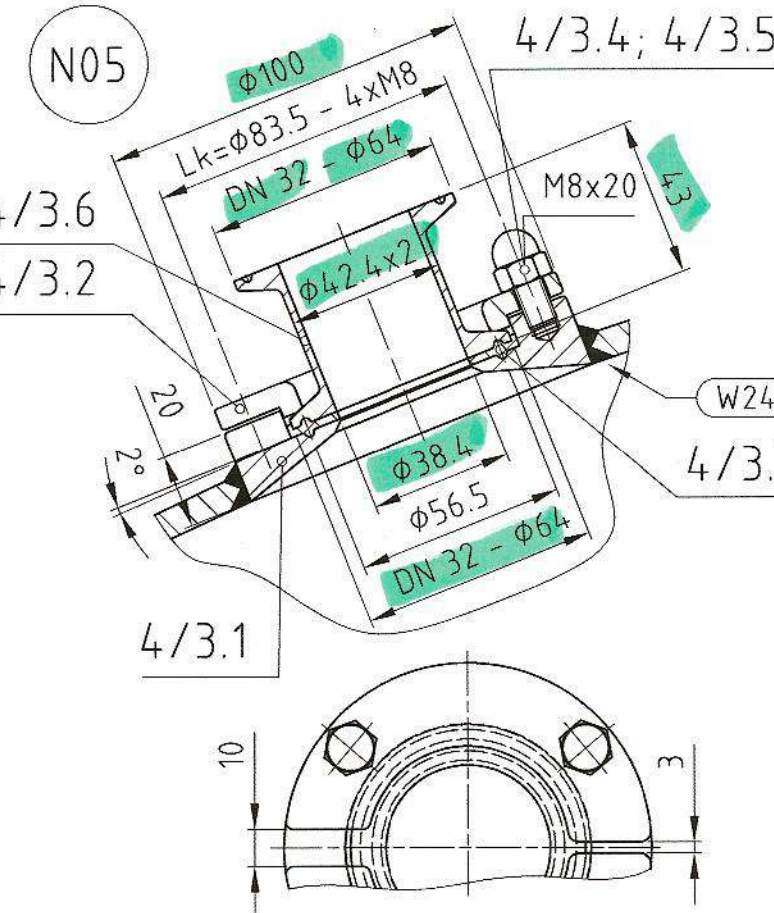


Druckanzeige, Drucksensor M 1:2

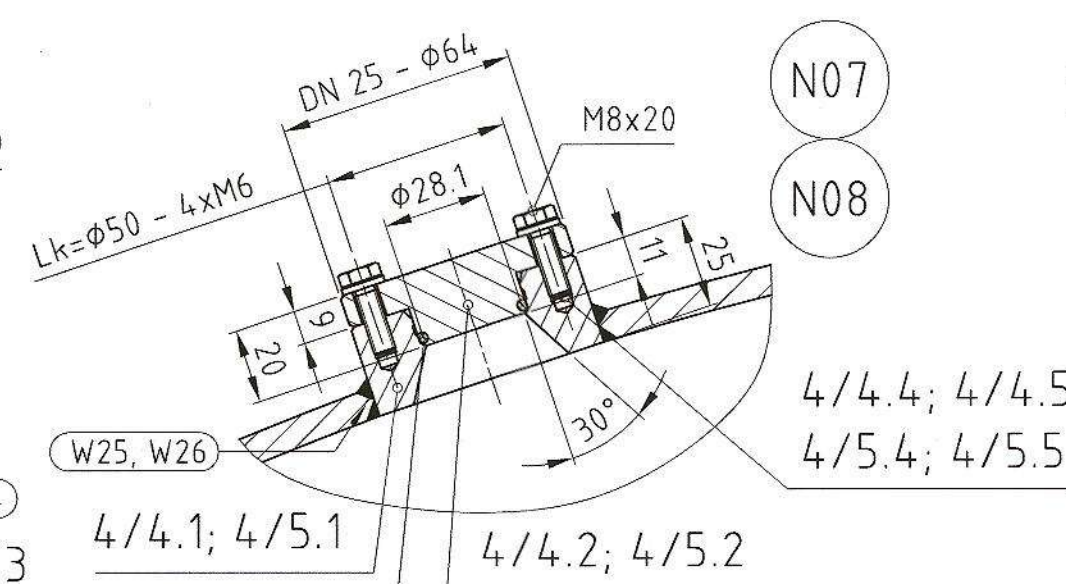


Füllstand M 1:2,5

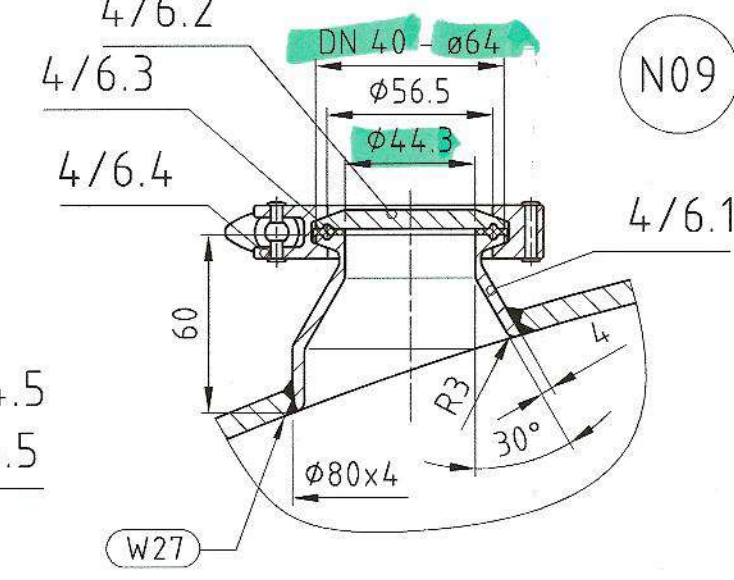


Schweißende HRS M 1:2

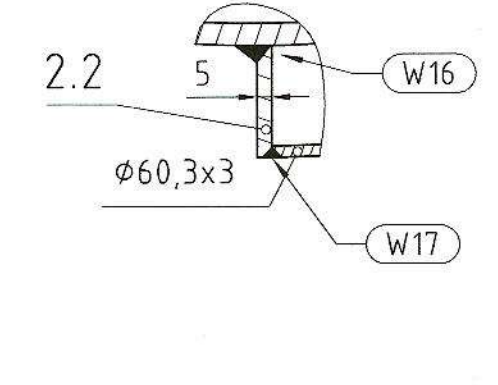


Verbindung HRS M 1:1

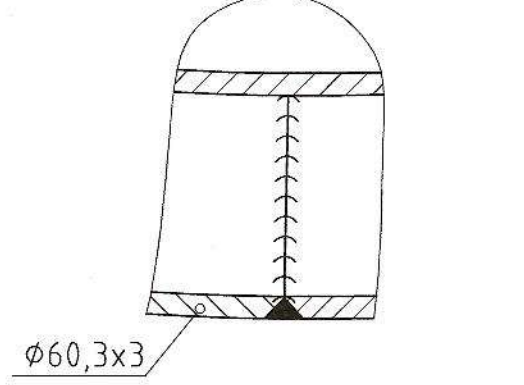


Detail Z M 5:1

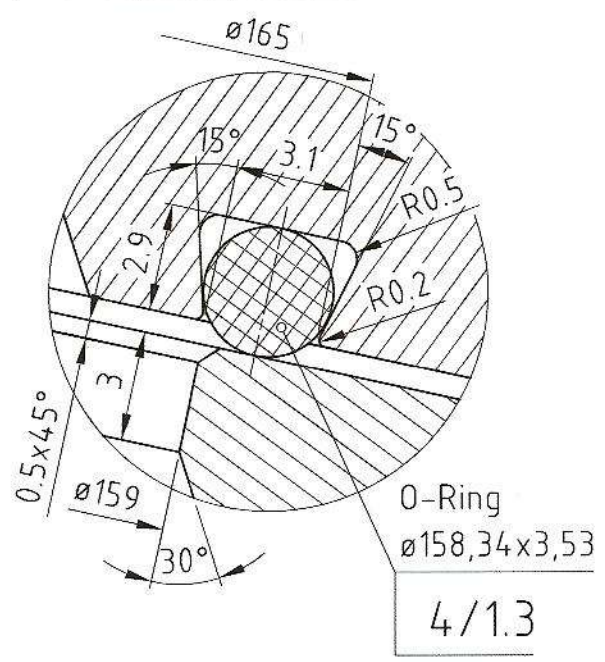

Niveauschalter M 1:2

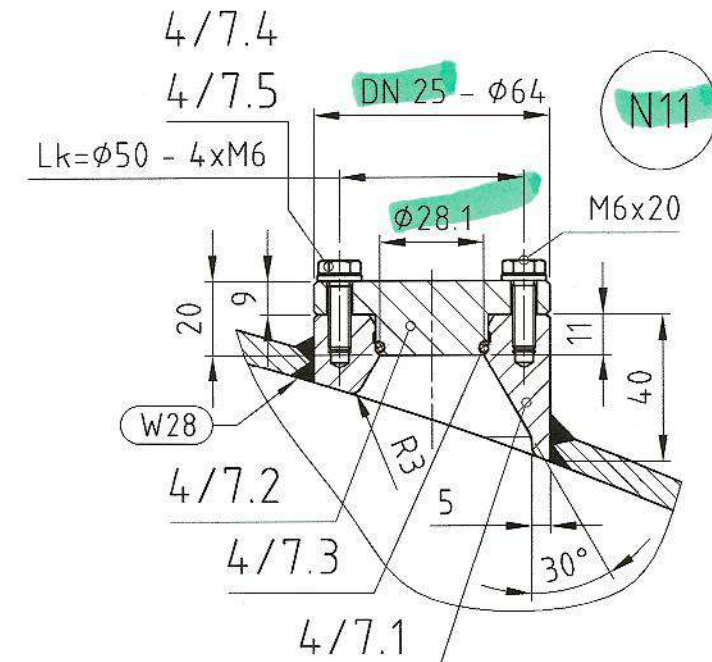


Be-/Entlüftung M 1:2

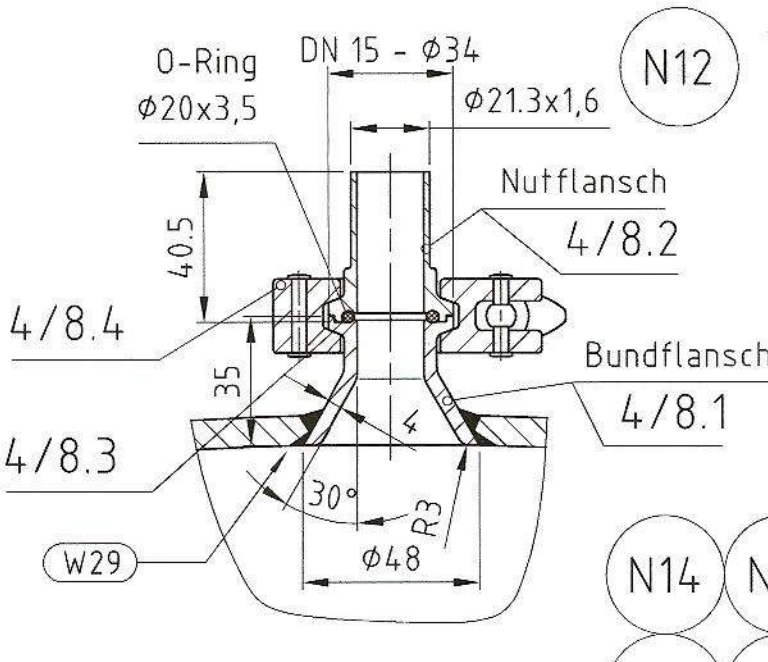


Bodenauslauf, Temperaturmessung M 1:2

Fabr. Endress+Hauser, Type TTSP-WT2037+HIJAZ1


Bodensitzventil DN 25
Fabr. Südm, Type: SVP Select A 386 D-E 30°
Aseptikausführung mit P³ Manschette
luftöffnend-federschließend
Inkl. Ventilanschaltung Fabr. Gemü Typ: 4242

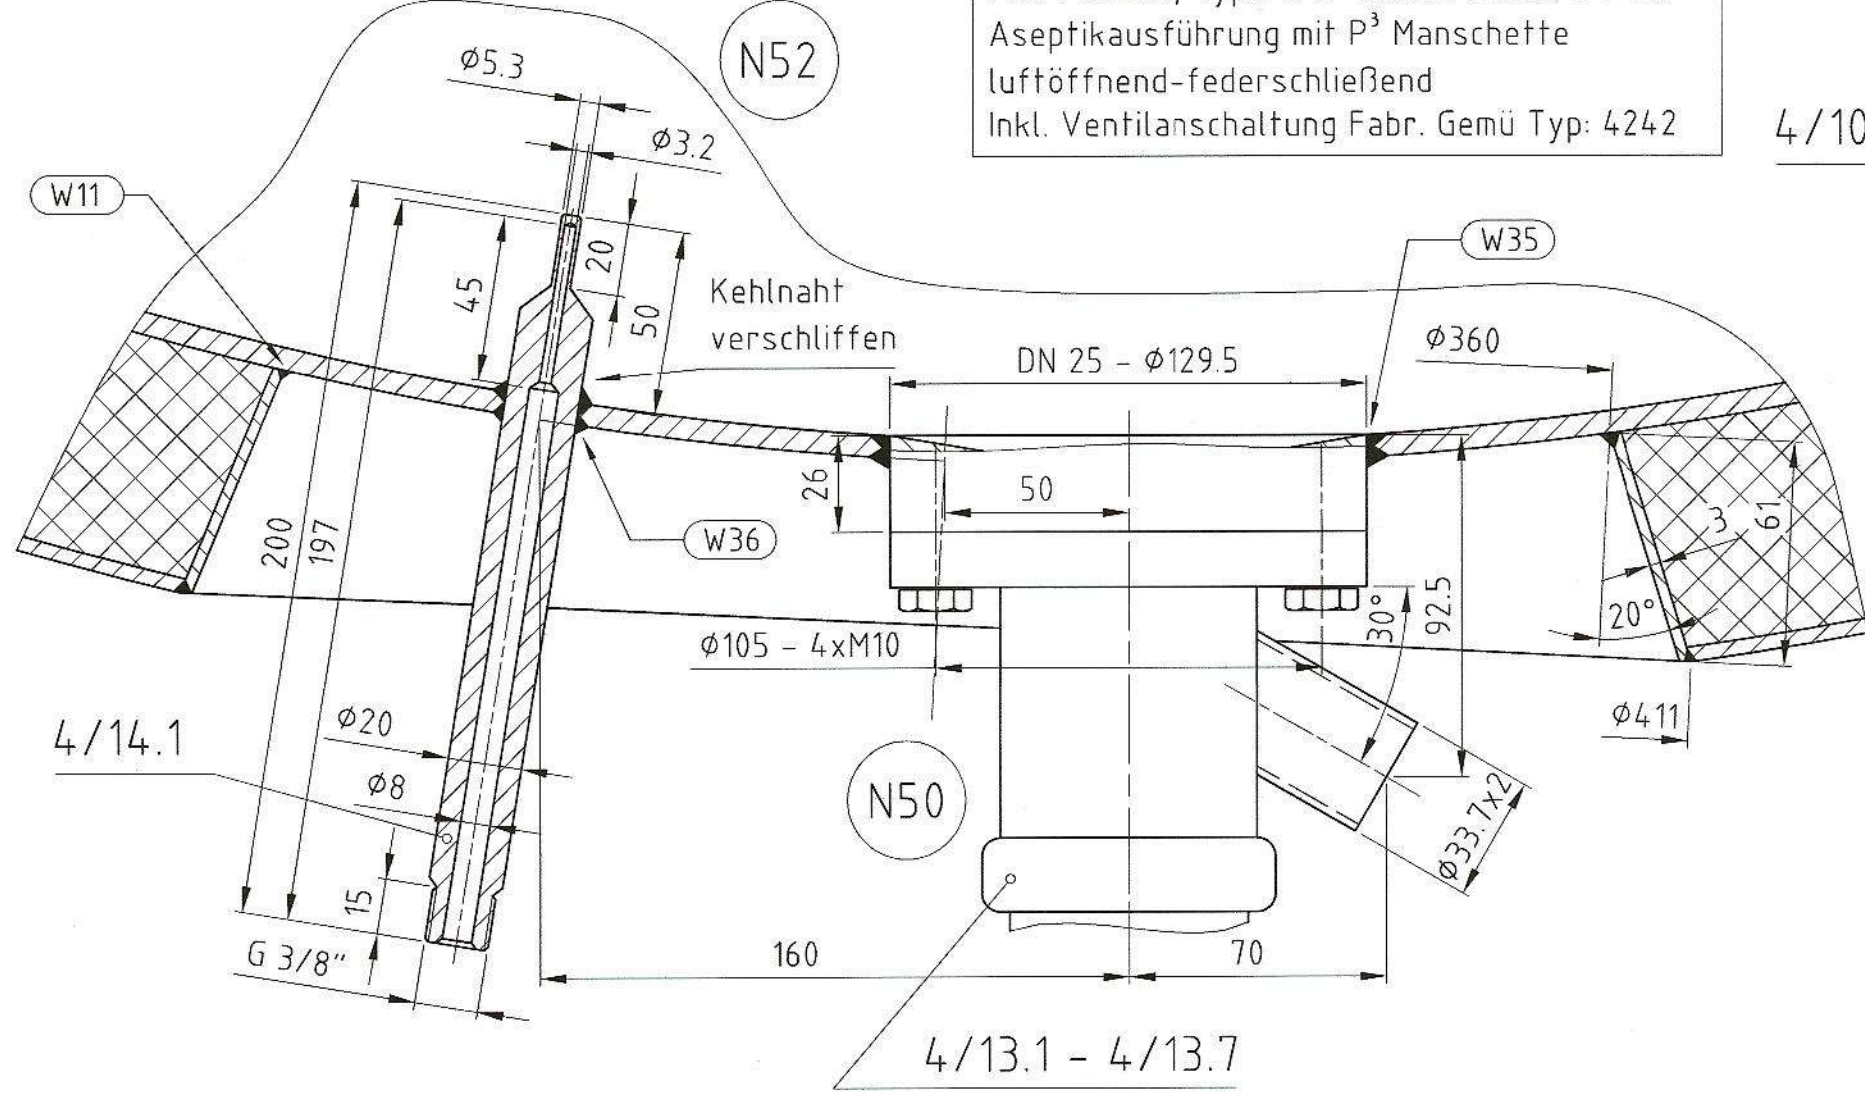


CIP 1, CIP 2 M 1:2

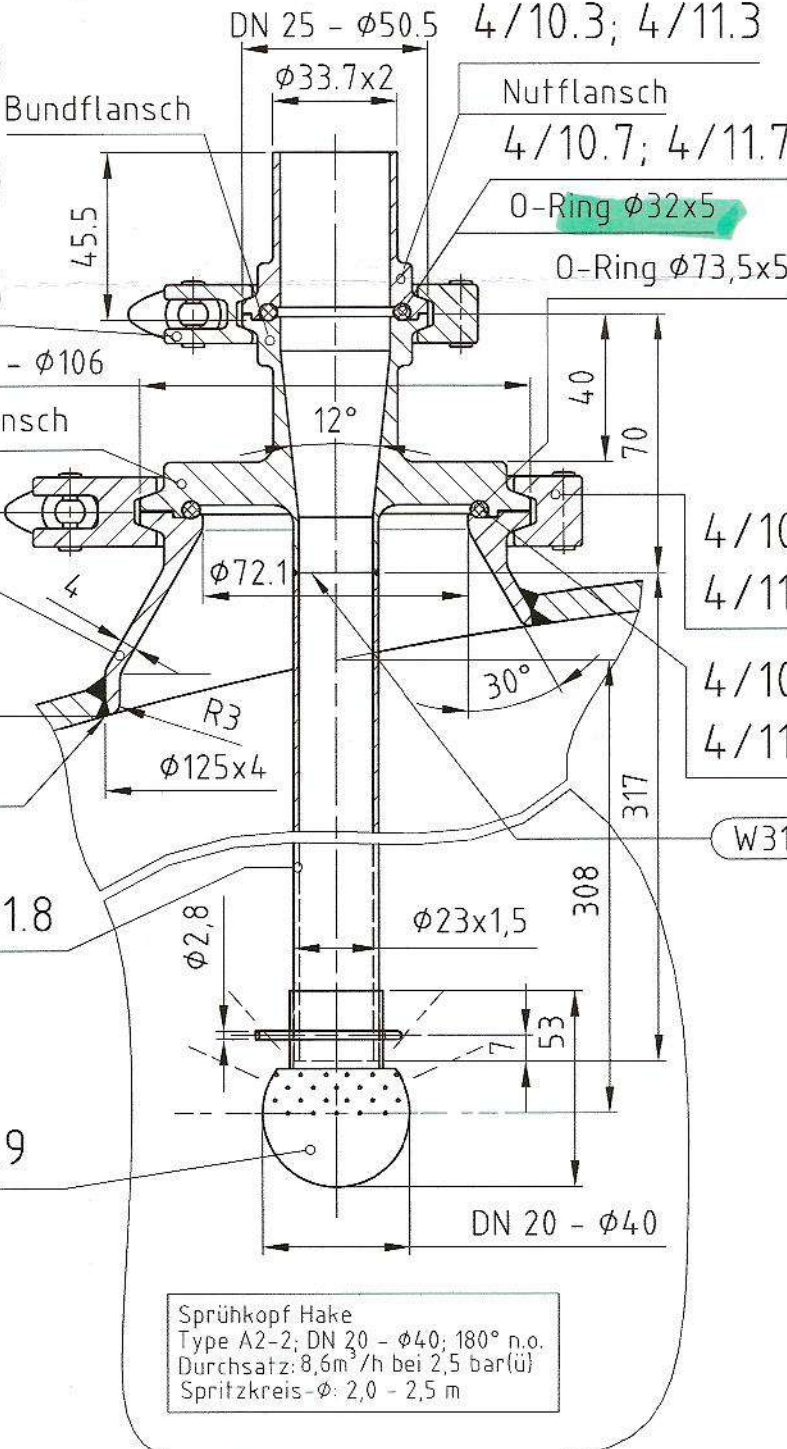


Einlaufrohr M 1:2

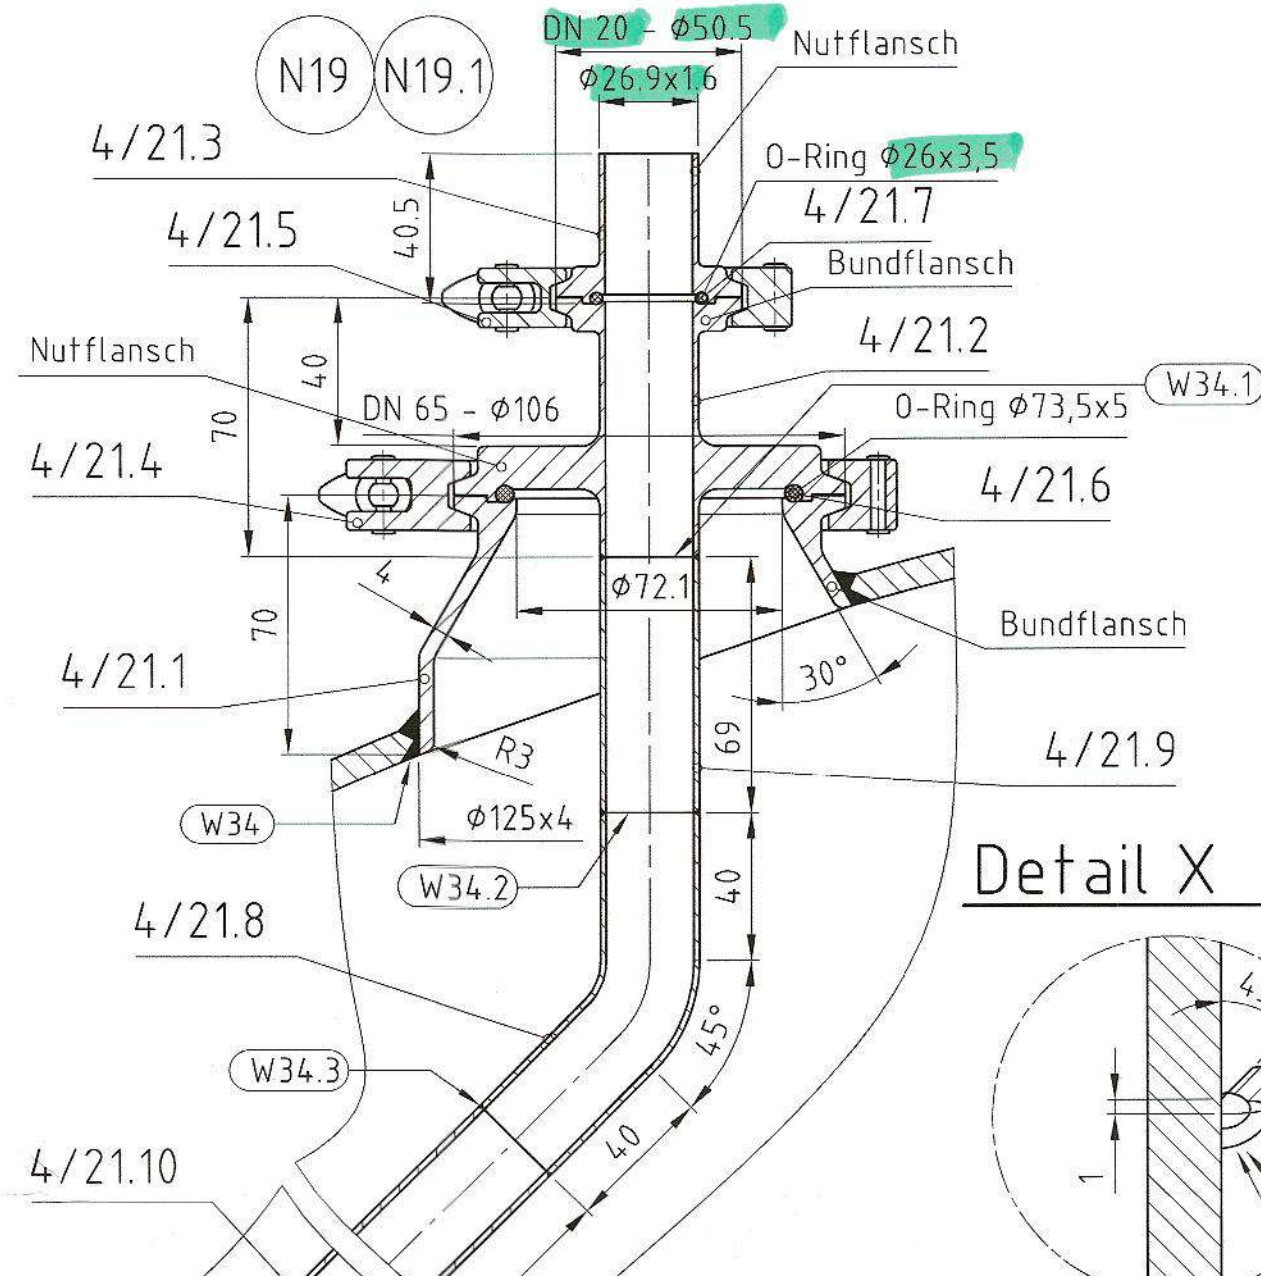


Detail X M 2:1

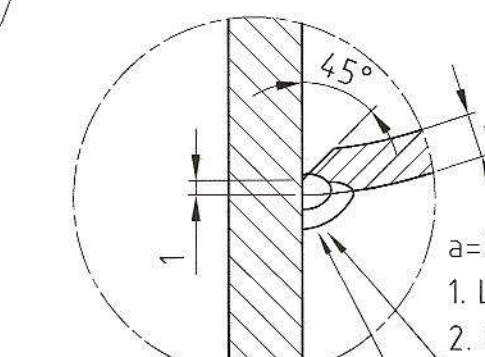


Biegeschenkel M 1:2,5

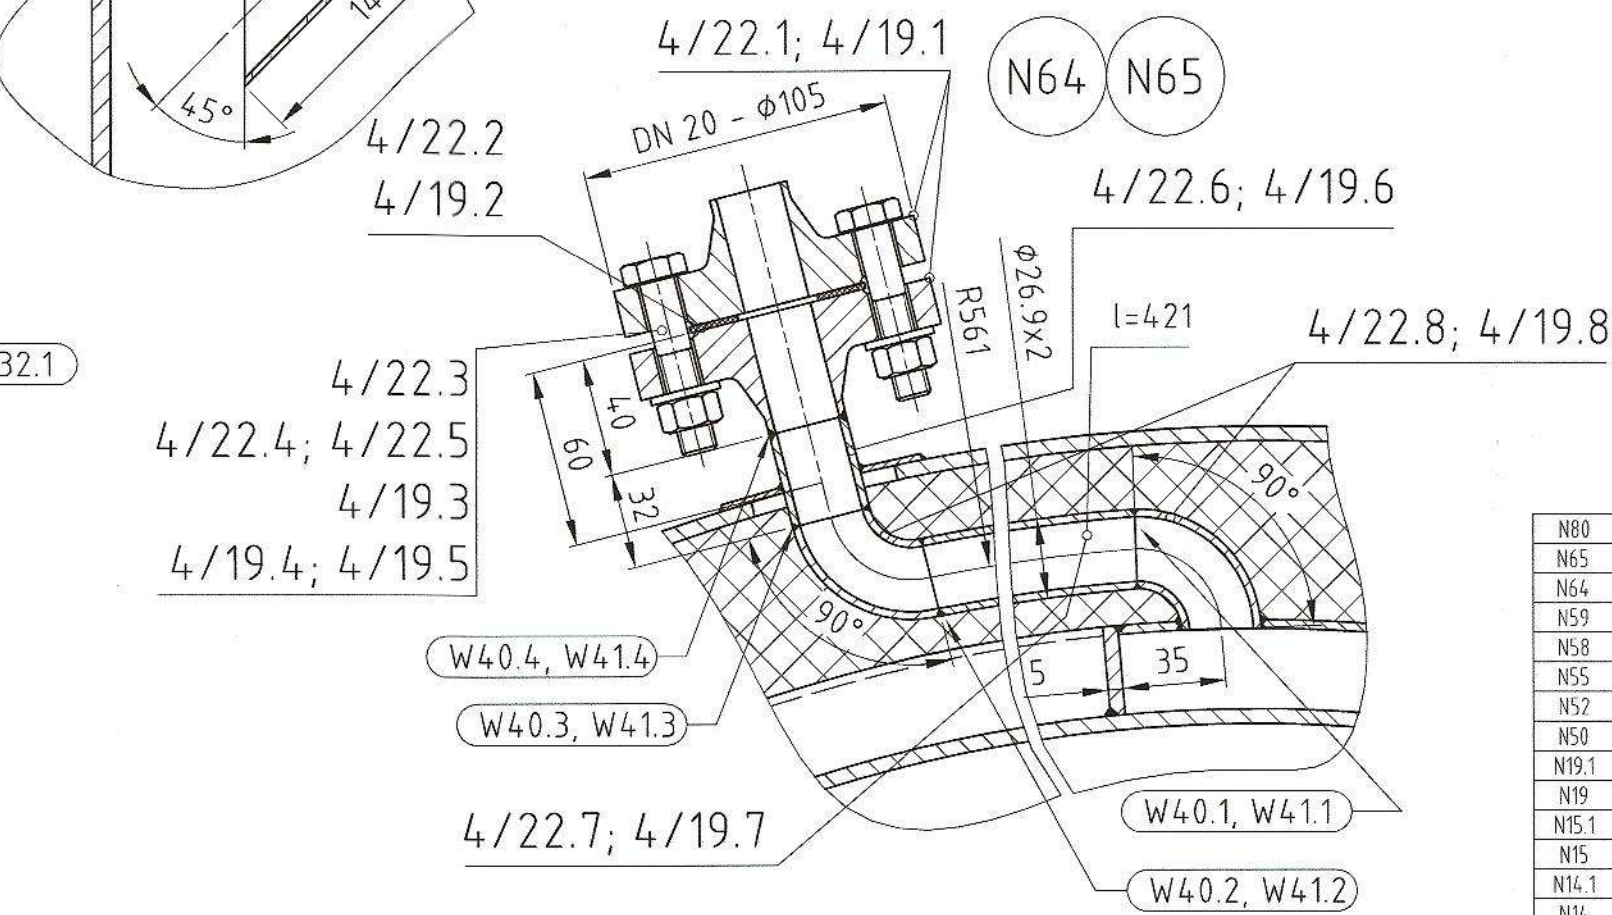


Mantelduplikat M 1:2,5

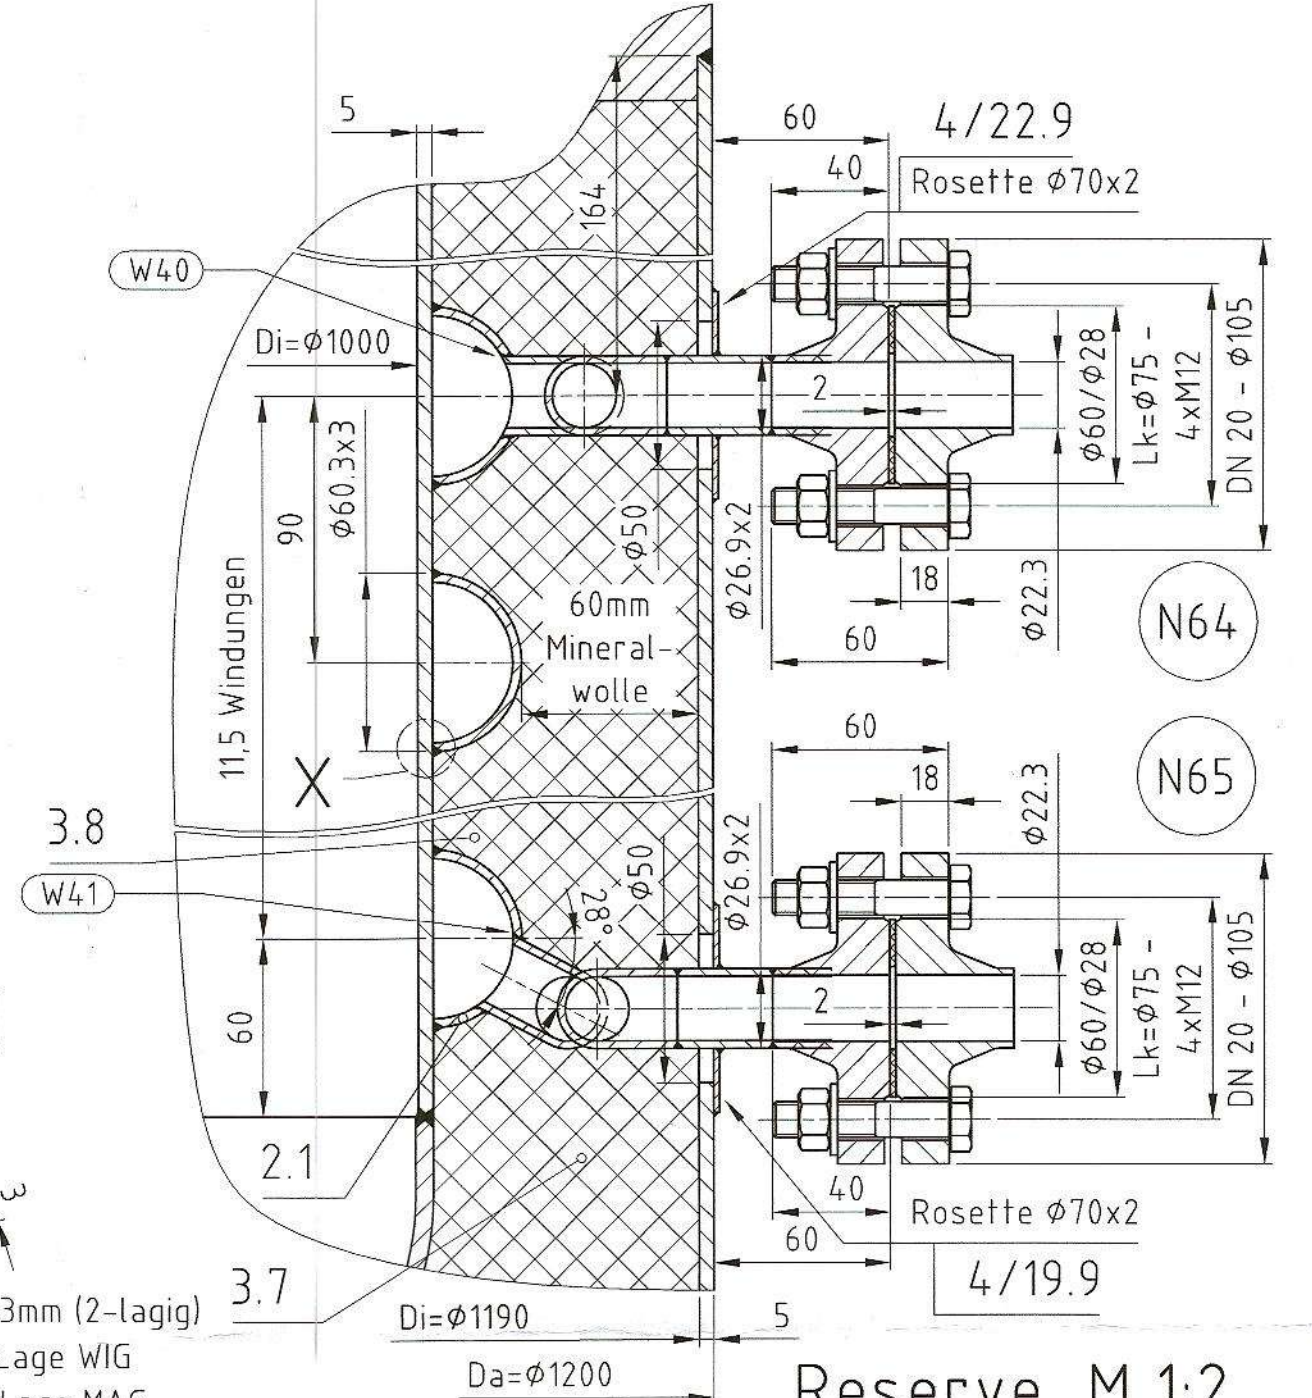


Reserve M 1:2

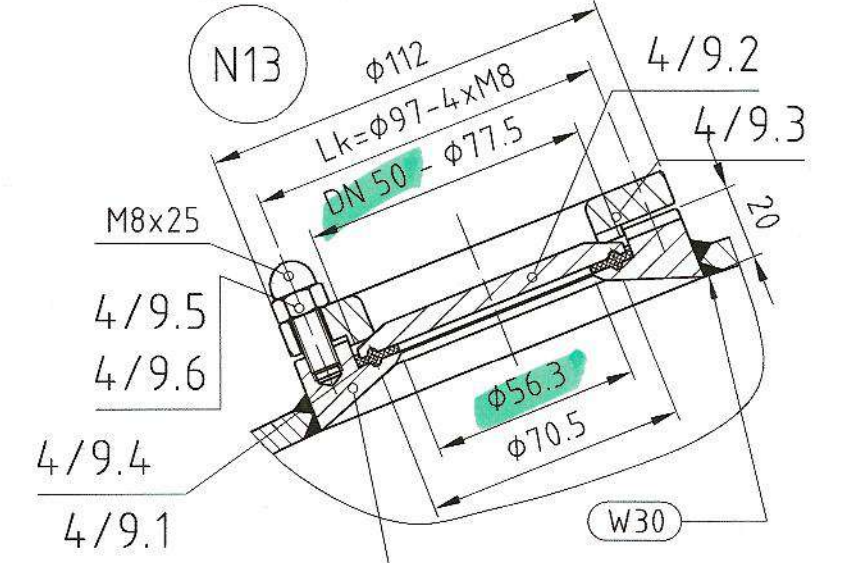


Probenahme M 1:2

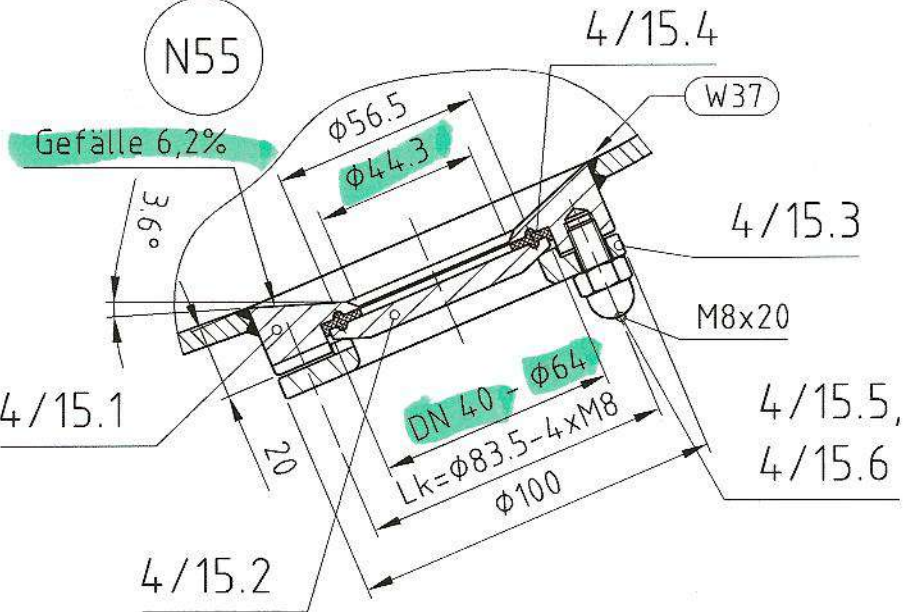


Reserve (pH) M 1:2

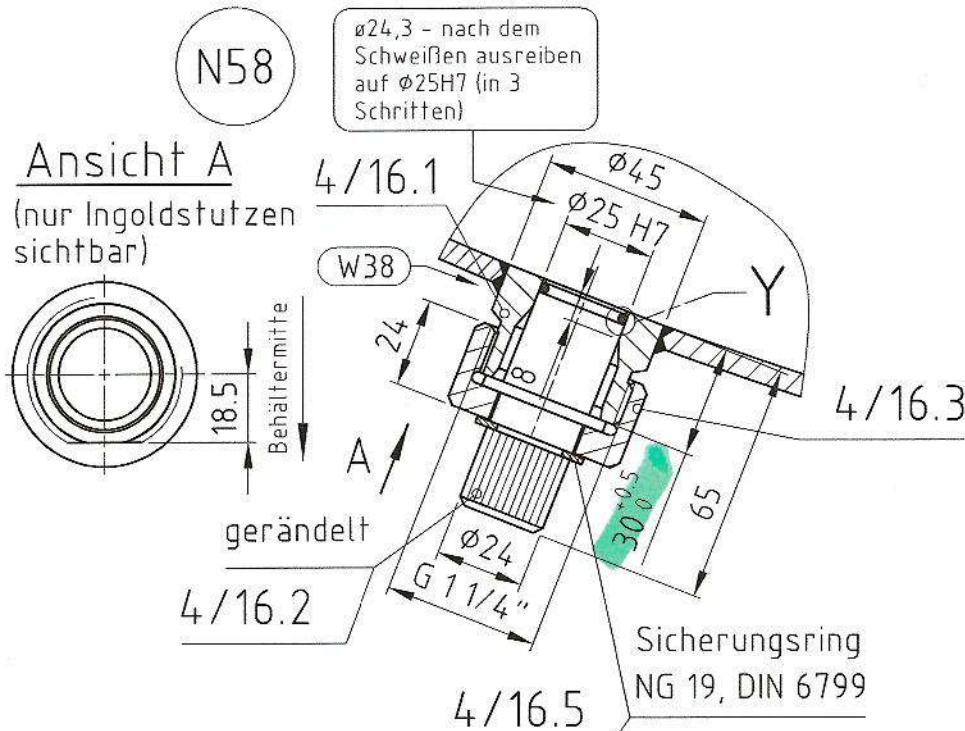


Detail Y M 5:1

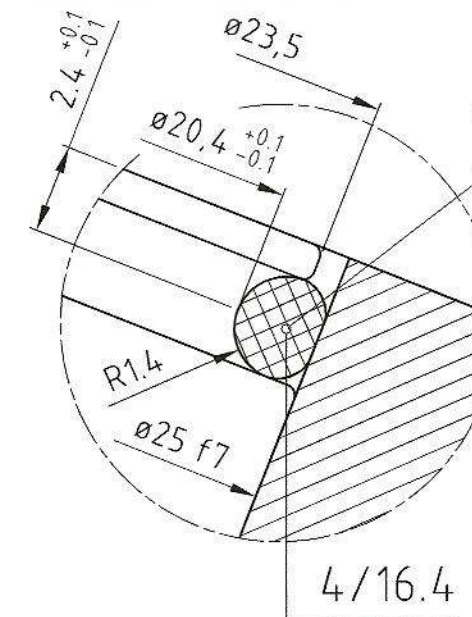

Reserve (Leitfähigkeit) M 1:2,5

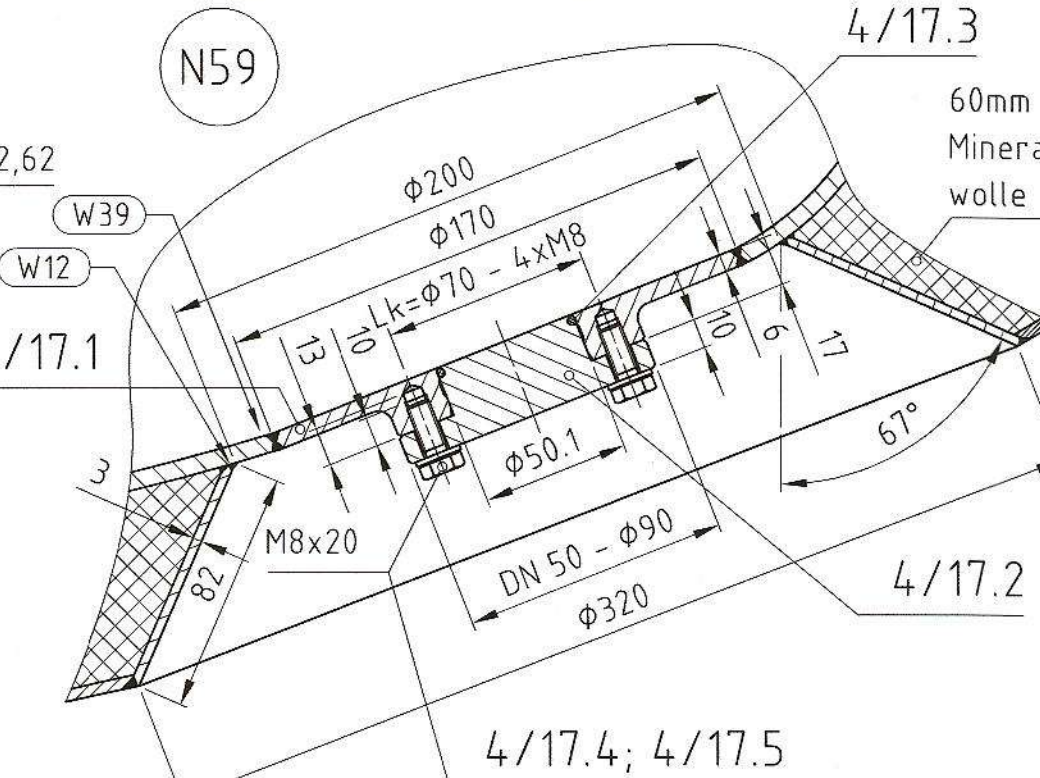

Prüfmuffe für Isolierung M 1:2

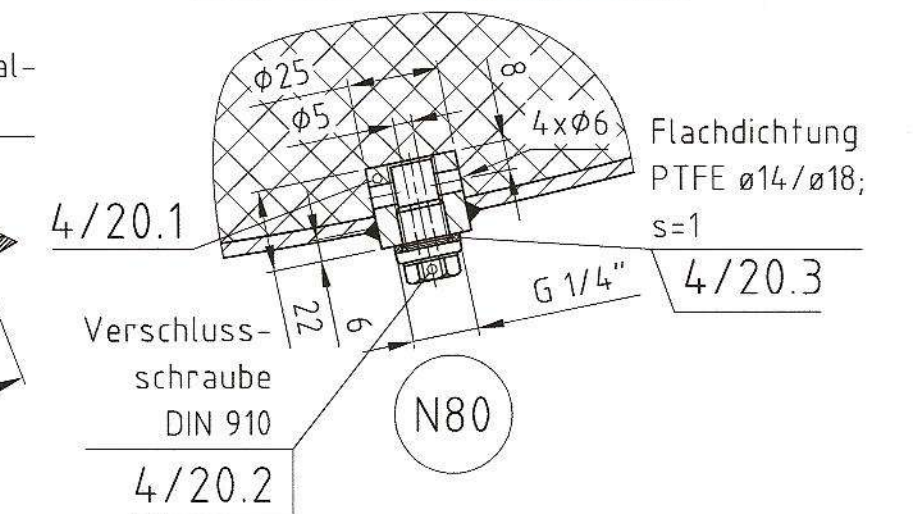

Pos.	Stk.	Verwendung	DN	PN	Norm	Roht	Benennung
N80	1	Prüfmuffe für Isolierung	20	40	EN 1091-V1/pt1	ø26,9x2	V-Flansch mit Gegenflansch
N84	1	Duplikat Austritt	20	40	EN 1091-V1/pt1	ø26,9x2	V-Flansch mit Gegenflansch
N59	1	Reserve (Leitfähigkeit)	50	16			0143 - Neumo BioControl m. Blindfl.
N58	1	Reserve (pH)	G 1/4"				0330 - Ingoldstutzen m. Blindstopfen
N55	1	Probenahme	ø40	7	DIN 32076	ø48,3x2	0304 - NA-Connect inkl. Blinddeckel
N52	1	Temperaturmessung	G 3/8"				0352
N50	1	Bodenauslauf	25	6	ø33,7x2		0388 - Fabr. Südm SVP Select A 386 D-E
N19	1	Einlaufrohr	ø50	40	DIN 11864-3	ø26,9x2	0349 - Aseptik-Clampapar Form A
N19	1	Aufnahme Einlaufrohr	ø50	25	DIN 11864-3	ø16,5x2	0349 - Aseptik-Bundclampsutzen Form A
N15	1	CIP 2	25/20	40	DIN 11864-3	ø33,7x2/ø23x1,5	0350 - Aseptik-Clampapar Form A
N15	1	Aufnahme CIP 2	ø50	25	DIN 11864-3	ø16,5x2	0350 - Aseptik-Bundclampsutzen Form A
N14	1	CIP 1	25/20	40	DIN 11864-3	ø33,7x2/ø23x1,5	0350 - Aseptik-Clampapar Form A
N14	1	Aufnahme CIP 1	ø50	25	DIN 11864-3	ø16,5x2	0350 - Aseptik-Bundclampsutzen Form A
N13	1	Reserve	ø50	7	DIN 32076	ø60,3x2	NA-Connect inkl. Blinddeckel
N12	1	Be-/Entlüftung	15	25	DIN 11864-3	ø21,3x2	0350 - Aseptik-Clampapar Form A
N11	1	Niveauschalter	ø25	16			0142 - Neumo BioControl m. Blindfl.
N09	1	Füllstand	ø40	16	DIN 32076	ø48,3x2	0344 - Tri-Clamp m. Blinddeckel
N08	1	Drucksensor	25	16			0143 - Neumo BioControl m. Blindfl.
N07	1	Druckanzeige	25	7	DIN 32076	ø42,5x2	0125 - NA-Connect inkl. Distanzstücke
N04	1	Lichtglas	ø50	16	DIN 11864-3		0348 - Fabr. Metaglas, Typ 85 mit Leuchte
N03	1	Schauglas	ø50	16			0106 - Fabr. Metaglas, Typ 19 Bio

AMERIKUNEN	Index	Datum	Name	Bezeichnung
b	10.08.17	Seifr.	Kundenänderungen vom 26.07.2017 sowie Stücklisten- und Schweißnahtpositionierung eingetragen.	
a	28.05.17	Seifr.	Kundenänderungen vom 14.06.2017 eingetragen.	


Das Urheberrecht an dieser Zeichnung verbleibt uns. Sie darf ohne unsere ausdrückliche Genehmigung weder vervielfältigt noch Dritten Personen, insbesondere Wettbewerbern, überlassen oder sonstwie zugänglich gemacht werden.
(§ 1 Nr. 3 des Gesetzes vom 19. Juni 1901)

HINKE TANKBAU GMBH
Frankenburgerstraße 2
A-4870 Vöcklabruck
Tel.: (0043) 07682/3660-0
Fax: (0043) 07682/3660-60
E-Mail: office@hinke.com

Maßstab	Datum	Name
1:5	26.06.2017	Seifrieds.
Form	Gezeichnet	
A1	Geprüft	
	Freigabe	

CSL Behring
1 Stk. Buffer Hold Vessel - 1040 Liter
TAG Nr.: 1B4100
Stutzen details

Z.-Nr. 6722-05/002b
Ersatz für: 6722-05/002a
Ersetzt durch:

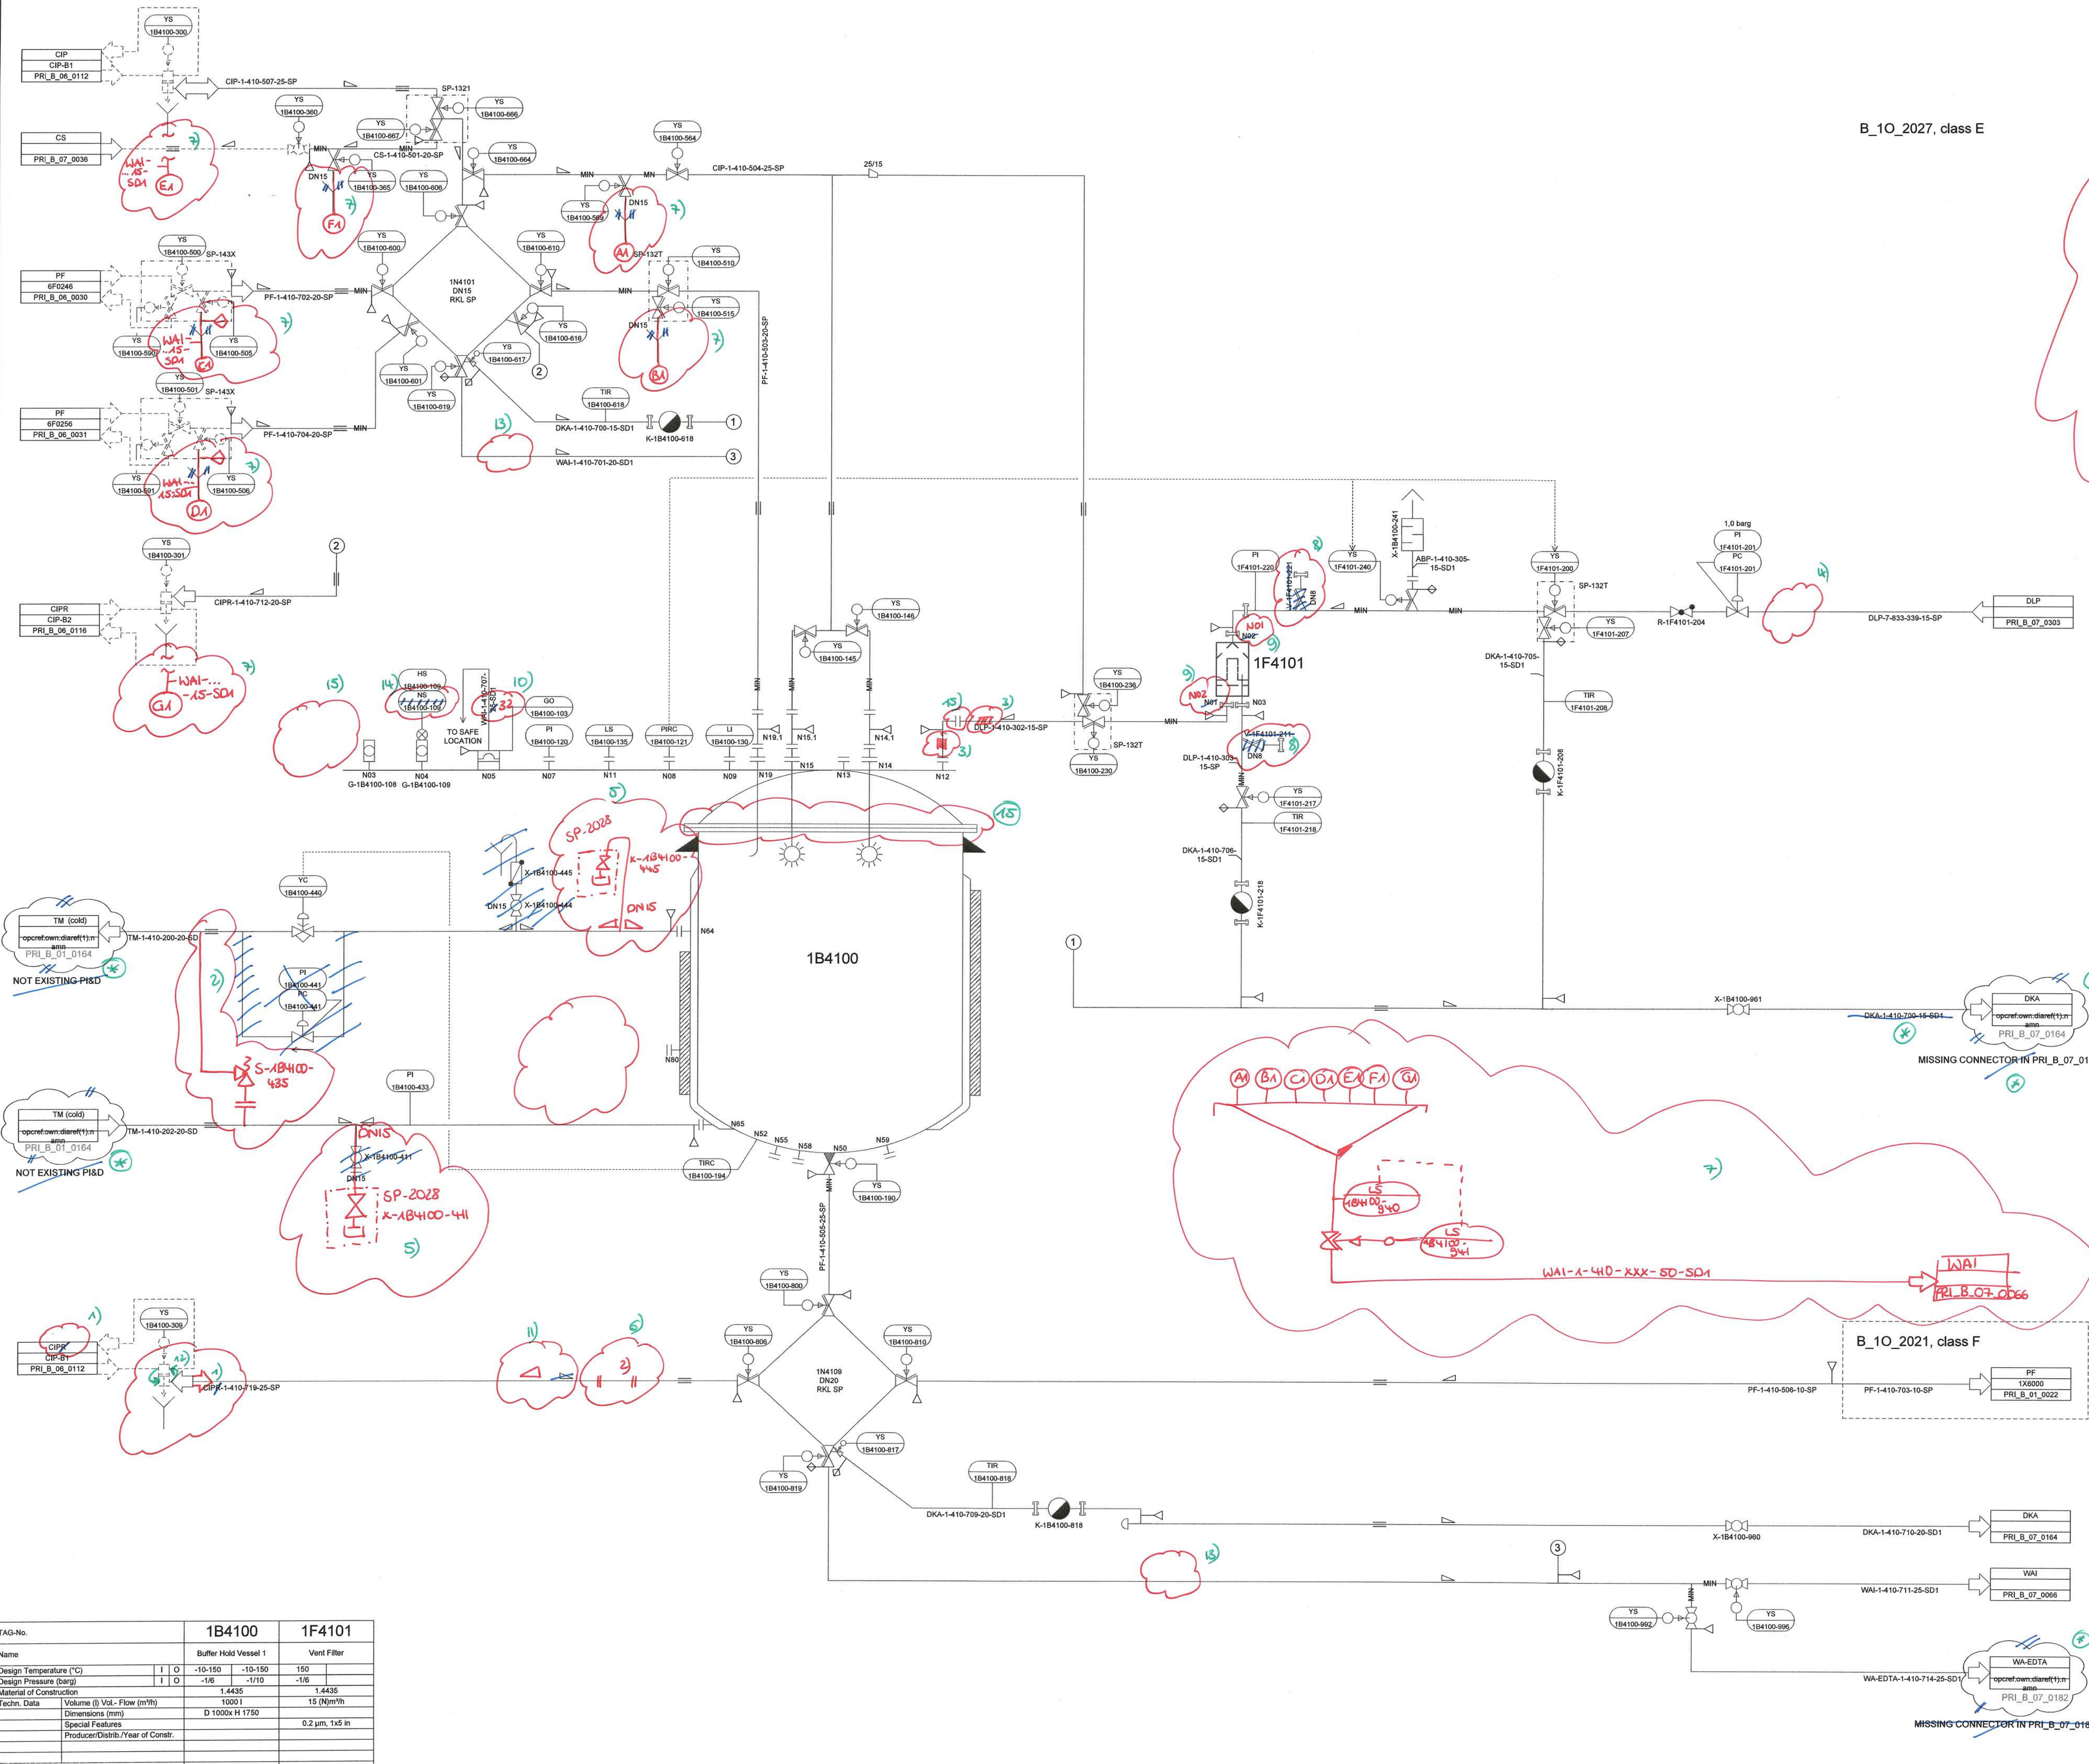


B_10_2027, class E

B_10_2021, class F

Notes:

- 1) Double block and bleed principle applied at the interfaces between CIP and product, media / buffer, clean utilities. Only double block applied for lines which would lose their sterile status by bleeding.
- 2) Number and location of funnels to be defined in next project phase based on 3D design.

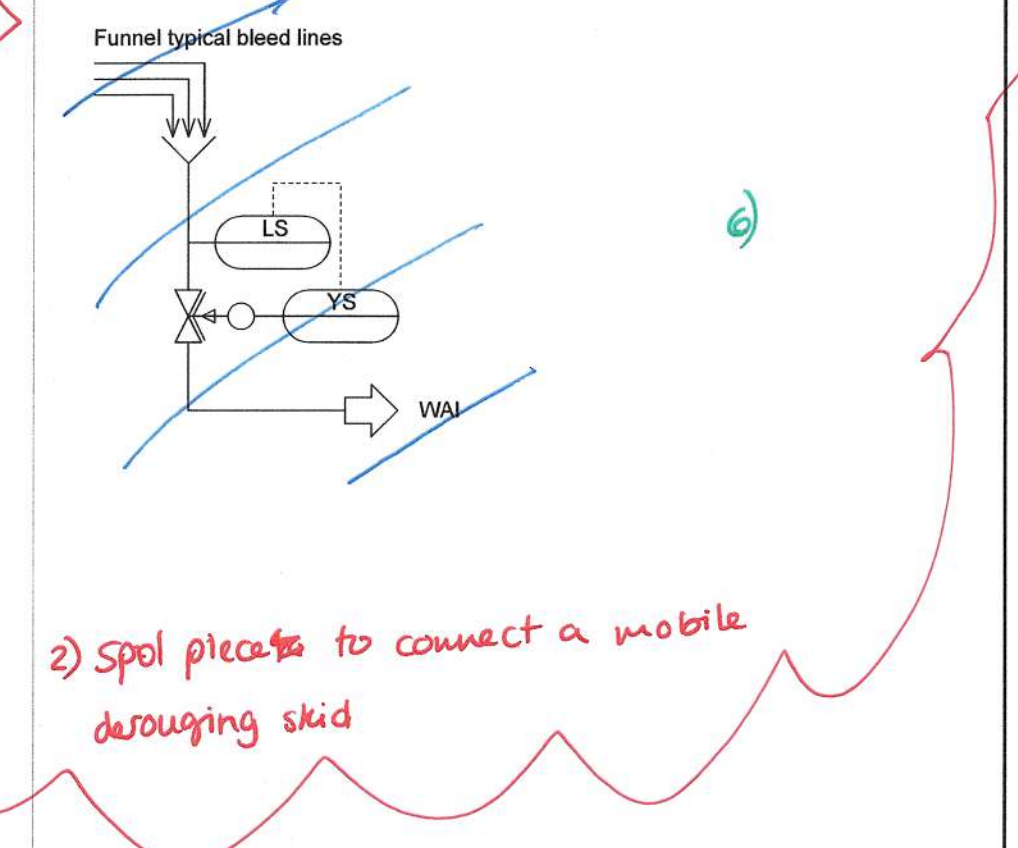

Master
07.06.17 NST

- 1) 12.06.17 / NST
- 2) 11.07.17 / NST
- 3) 13.07.17 NST
- 4) 12.6.17 NST
- 5) 11.07.17 NST
- 6) 11.07.17 NST
- 7) 11.07.17 NST
- 8) 13.07.17 NST
- 9) 13.07.17 NST
- 10) 3.8.17 NST
- 11) 3.8.17 NST
- 12) 3.8.17 NST
- 13) 12.6.17 NST
- 14) 2.8.17 NST
- 15) 3.8.17 NST

12.06.17 NST

TAG-No.	1B4100	1F4101
Name	Buffer Hold Vessel 1	Vent Filter
Design Temperature (°C)	-10-150 / -10-150 / 150	
Design Pressure (bar(g))	-1/6	-1/6
Material of Construction	1.4435	1.4435
Techn. Data	Volume (l) Vol.-Flow (m³/h)	1000 l / 15 (Nm³/h)
Dimensions (mm)	D 1000x H 1750	
Special Features	0.2 µm, 1x5 in	
Producer/Distrib./Year of Constr.		
Remarks		

Client Project No.: 19304	CSL Behring CSL Behring Recombinant Facility AG Wankdorfstrasse 10 CH-3000 Bern 22, Switzerland																				
Architect Project No.:	ANS ANS Architekten und Planer SIA AG Hauptstrasse 14 3076, Worz, Switzerland Telefon: +41 31 838-8080 Telefax: +41 31 838-8085																				
General contractor Project No.:	M+W Central Europe GmbH Business Unit Life Sciences and Process Facilities Lottnerstrasse, 30 70499, Stuttgart, Germany Telefon: +49 711 8804-1800 Telefax: +49 711 8804-1865																				
Design Partner Project No.:	M+W Central Europe GmbH Business Unit Life Sciences and Process Facilities Lottnerstrasse, 30 70499, Stuttgart, Germany Telefon: +49 711 8804-1800 Telefax: +49 711 8804-1865																				
Revision table & DATE	<table border="1"> <tr> <th>NO.</th> <th>DATE</th> <th>DESCRIPTION</th> <th>BY</th> <th>CHKD.</th> </tr> <tr> <td>01</td> <td>02.06.17</td> <td>Update after AFD</td> <td>...</td> <td>...</td> </tr> <tr> <td>02</td> <td>03.06.17</td> <td>Update - Submission to AFD</td> <td>...</td> <td>...</td> </tr> <tr> <td>03</td> <td>20.06.17</td> <td>Final Issue</td> <td>...</td> <td>...</td> </tr> </table>	NO.	DATE	DESCRIPTION	BY	CHKD.	01	02.06.17	Update after AFD	02	03.06.17	Update - Submission to AFD	03	20.06.17	Final Issue
NO.	DATE	DESCRIPTION	BY	CHKD.																	
01	02.06.17	Update after AFD																	
02	03.06.17	Update - Submission to AFD																	
03	20.06.17	Final Issue																	
Project Name & DATE	CSL Behring AG RCF Project Lengnau 02.03.16																				
Scale	SCALE: 1/84 100 LAYOUT SCALE:																				

Data Sheet Vessel

1B4100 Buffer Hold Vessel 1 (C1 Wash 2)

1 (rVIII-SC) / 1UB41 Buffer Hold Chroma 1

Version 08

Status: As Built

This datasheet does also apply to:

3B4550

2B4800


Total number: 3

History:


Vers. Date

08.0	21.11.2017
07.0	26.10.2017
06.0	19.12.2016
05.0	08.12.2016
04.0	25.07.2016

Function	Company	Name	Date	Signature
Author	M+W	<i>Aku</i>	21.11.2017	<i>A. Fahl</i>
Review	<i>M+W</i>	<i>Sch</i>	<i>21.11.2017</i>	<i>[Signature]</i>
Approval				
CSL Behring			M+W	
<p>CSL Behring Biotherapies for Life™</p> <p>CSL Behring Recombinant Facility AG Wankdorfstrasse 10 CH-3000 Bern 22 Switzerland</p>			<p> M+W GROUP</p> <p>M+W Central Europe GmbH Lotterbergstr. 30 D-70499 Stuttgart Germany</p>	
Project Number CSL Behring 16004			Project Number M+W 2304996	
Document Number CSL Behring			Document Number M+W D-P-DA-0006	Version 08.0
Project RCF Project Lengnau			Document Type / Description Data Sheet	Page 1

Project-No.		2304996		Data Sheet								
Code		NRCFF		Vessel								
Tag-No.		1B4100										
PFD-No.		PVF_B_01_0060		Building-No.		B		Process		1 (rVIII-SC) / 1UB41 Buffer Hold Chroma 1		
P&ID -No.		PRI_B_01_0070		Level		10		Name		Buffer Hold Vessel 1 (C1 Wash 2)		
Drawing-No.		6722-05 001/002		Room-No.		B_10_2027		Type		Vessel		
01		General								Design Data		
02	7	Inquiry No. / Date	N/A /		0		Pressure Vessel Code	AD2000; PED				
03	7	Bid No. / Date	11198/17E / 02.03.2017		5	v	Inside Diameter	1000	mm			
04	7	Order No. / Date	4500971526 / 27.04.2017		7	v	Length w/o Support	1760	mm			
05	7	Standard / Regulation	RS.000 - 36/37/39/40/41		7	v	Bottom Outlet Height	N/A mm				
06	7	Inspection	RS.000 - 36/37/39/40/41		5		Nominal volume	1000	l			
07	7	Manufacturer / Supplier	Hinke Tankbau / Hinke Tankbau		7	v	Total volume	1270	l			
08	7	Necessary Certificates	RS.000 - 36/37/39/40/41				Design Temperature					
09	7	Documentation	RS.000 - 36/37/39/40/41		6	v	Inside	-10-150	°C			
10	0				6	v	Jacket (Heating / Cooling)	-10-150	°C			
11	0						Design Pressure²					
12		Operating Data						2	v	Inside	-1 / 6	bar
13	4	Medium	Process Media		0	v	Jacket (Heating / Cooling)	-1 / 10	bar			
14	4	Characteristics	aqueous solution		0	v	Type of bottom	dished end DIN 28011				
15	7	Working Volume min./max.	115,5	- 1040	l	0	Type of top	dished end DIN 28011				
16	7	Operating Temp. Min./max.	19	- 23	°C		Wall Thickness					
17	7	Op. Pressure min./max.²	0	- 2,1	bar	7	Top / Bottom / Cylinder	8 / 6 / 5	mm			
18	7	Filling Rate min./max.	N/A		m ³ /h	7	Heating-/ Cooling Jacket	3	mm			
19	7	Draining Rate min./max.	N/A		m ³ /h	7	Inliner	N/A mm				
20	4	Density / Bulk Density at [T]	1200	20	kg/m ³ °C	7	Insulation / Insulation Jacket	5	mm			
21	7	Specific Heat Capacity	~4.2		kJ/kg K	0	Corrosion Allowance	0	mm			
22	4	Dynamic Viscosity at [T]	0.002	20	Pa s °C	7	Welding Factor	acc. PED				
23	4	pH-Value min./max.	1	- 14		0	Vessel Orientation	vertical				
24	4	Flash Point	N/A		°C	7	Reinforcing Sheet(s)	no				
25	4	Inertisation ²	N/A		mbar	7	Test press. in-/outside²	11.3 / 18.1	bar			
26	0	Cleaning in Place	Yes			7	Gaskets / Type	acc. pipe class				
27	0	Medium	0.5M NaOH, 0.1M HNO3			7	Heat Ex. Surface / Content	N/A	m ² / l			
28	0	Temperature	<=80		°C		Weight of Vessel					
29	0	Sterilisation in Place	Yes			7	Empty / Disaster	950 / 2262	kg			
30	0	Medium	pyrogen free steam				Construction Details					
31	0	Temperature	<135		°C	2	Heating / Cooling	cylinder				
32	0	Heating-/Cooling Medium	Tempering Media			7	Type	coil				
33	0	Inlet Temperature	14		°C		Support					
34	0	Outlet Temperature	20		°C	7	Type / No. / Norm	brackets / 4 /				
35	0	Operating Pressure ²	~3		bar		Fixing					
36	0	Density at [T]	1000	25	kg/m ³ °C	7	Type / No. / Norm	lifting lugs / 3 /				
37	0	Specific Heat Capacity	4,182		kJ/kg K	7		name plate / 1 /				
38	0	Dyn. Viscosity at [T]	0,001	25	Pa s °C	0		Earthing Connector/ 1 /				
39	7	Thermal Output (max)	N/A		kW	0		/ /				
40	7	Thermal Input (max)	N/A		kW	0	Accessories	/ /				
41	7	Heating-/ Cooling Rate	N/A	/	N/A °C/min	0	Type / No. / Norm	/ /				
42	0	Insulation	yes			0		/ /				
43		Materials						0		/ /		
44	0	Product Contacted Parts	1.4435			0	Agitator seal					
45	5	d-Ferrite Content	Fe <3%			0	Arrangement	none				
46	7	Gaskets	EPDM peroxid cured			0	Aseptic Design	yes				
47	0	Sight Glasses	DIN 7080			0						
48	0	Inliner	N/A				Surface Treatment					
49	7	Non Prod. Contacted Parts / Insulation Jacket	coil:1.4571 rest:1.4301				Outer surface					
50						7	Surface finish	grinded				
51	0	Gaskets	Gylon			2	Surface Roughness	RA <=1.2µm				
52	7	Supports	1.4301			6	Welding Seam	polished eg. Scotch bride				
53	7	Insulation	Fabr. ISOVER, AGI Q132			v	Inner surface					
54	2	Screws, Nuts, Bolts	A2-70; A4			6	Surface finish	grinded				
55		Exterior coating				2	Surface properties	RA <=0.6µm				
56	7	Primer	N/A			2	Welding Seam	grinded				
57	7	Final Coating	N/A			0						
58	0											
59		Remarks										
60		1. Lines marked with "v" contain process information										
61		2. Overpressure. Vacuum is marked with a negative sign.										
62												
63	7											
64	7											
65	7											


Distribution of the original or copies of this document, further use or distribution of its content is not allowed without written permission from M+W. Violators will be obligated to pay fees and penalties.


Project-No.	2304996	Data Sheet				
Code	NRCFF					
Tag-No.	1B4100					
PFD-No.	PVF_B_01_0060	Building-No.	B	Process	1 (rVIII-SC) / 1UB41 Buffer Hold Chroma 1	
P&ID -No.	PRI_B_01_0070	Level	10	Name	Buffer Hold Vessel 1 (C1 Wash 2)	
Drawing-No.	6722-05 001/002	Room-No.	B_1O_2027	Type	Vessel	

Rev	Table of Nozzles							
	Ident.	No.	DN	PN	Norm	Flange-/Nozzletype	Sealing Face	Service
7	N03	1	150		similar DIN 26117	Block flange, radial	O-ring	0106 - Sight glass
7	N04	1	50		DIN 11864-3 BKS	Dim. DIN 11866-B	O-ring; Form A	0348 - Sight glass with light
7	N05	1	32		Dim. DIN 11866-B	Na-connect	Flat	0125 - Rupture disc
7	N07	1	B25			Neumo BioControl	O-ring	0142 - Pressure gauge
7	N08	1	B25			Neumo BioControl	O-ring	0142 - Pressure probe
8	N09	1	40		DIN 32676	Dim. DIN 11866-B	Flat	0344 - Filling level
7	N11	1	B25			Neumo BioControl	O-ring	0142 - Level switch
7	N12	1	15		DIN 11864-3 BKS	Dim. DIN 11866-B	O-ring; Form A	0351 - Ventilation
8	N13	1	50		Dim. DIN 11866-B	Na-connect	Flat	0304- Sampling (spare port)
7	N14	1	65		DIN 11864-3 BKS	Dim. DIN 11866-B	O-ring; Form A	0350 - CIP 1 (vessel-connection)
7	N14.1	1	25		DIN 11864-3 BKS	Dim. DIN 11866-B	O-ring; Form A	0350- CIP inlet 1
7	N15	1	65		DIN 11864-3 BKS	Dim. DIN 11866-B	O-ring; Form A	0350 - CIP 2 (vessel-connection)
7	N15.1	1	25		DIN 11864-3 BKS	Dim. DIN 11866-B	O-ring; Form A	0350 - CIP inlet 2
7	N19	1	65		DIN 11864-3 BKS	Dim. DIN 11866-B	O-ring; Form A	0349 - Inlet pipe (vessel-connection)
7	N19.1	1	20"		DIN 11864-3 BKS	Dim. DIN 11866-B	O-ring; Form A	0349 - Inlet pipe (J-tube)
2	N50	1	25		Südmo block flang	Type Südmo SVP	O-ring	0318 - Bottom outlet
7	N52	1	G 3/8"			Thermowell		0352 - Temperature measurement
7	N55	1	40		Dim. DIN 11866-B	Na-connect, Nova septum	Flat	0304 - Sampling
5	N58	1	G 1 1/4"		Ingold	25H7	O-ring	0330 - Spare (pH)
7	N59	1	B50			Neumo Biocontrol	O-ring	0143 - Spare (conductivity)
7	N64	1	20		DIN EN 1092-1 11	welding neck flange	Form B1	Outlet Tempering Media
7	N65	1	20		DIN EN 1092-1 11	welding neck flange	Form B1	Inlet Tempering Media
2	N80	1	1/4"		supplier standard	socket with thread		0149 - Testsocket insulation

Rev	Remarks Nozzles
2	Nozzle typical number: S-E-AT-XXXX(number in Service column)
7	*Bei Faktor IX Behältern DN25
0	
0	
0	
0	


Distribution of the original or copies of this document, or further use or distribution of its content is not allowed without written permission from M +W. Violators will be obligated to pay fees and penalties.

Project-No.	2304996	Data Sheet				
Code	NRCFF					
Tag-No.	1B4100					
		Vessel				
PFD-No.	PVF_B_01_0060	Building-No.	B	Process	1 (rVIII-SC) / 1UB41 Buffer Hold Chroma 1	
P&ID -No.	PRI_B_01_0070	Level	10	Name	Buffer Hold Vessel 1 (C1 Wash 2)	
Drawing-No.	6722-05 001/002	Room-No.	B_10_2027	Type	Vessel	
Sketch						

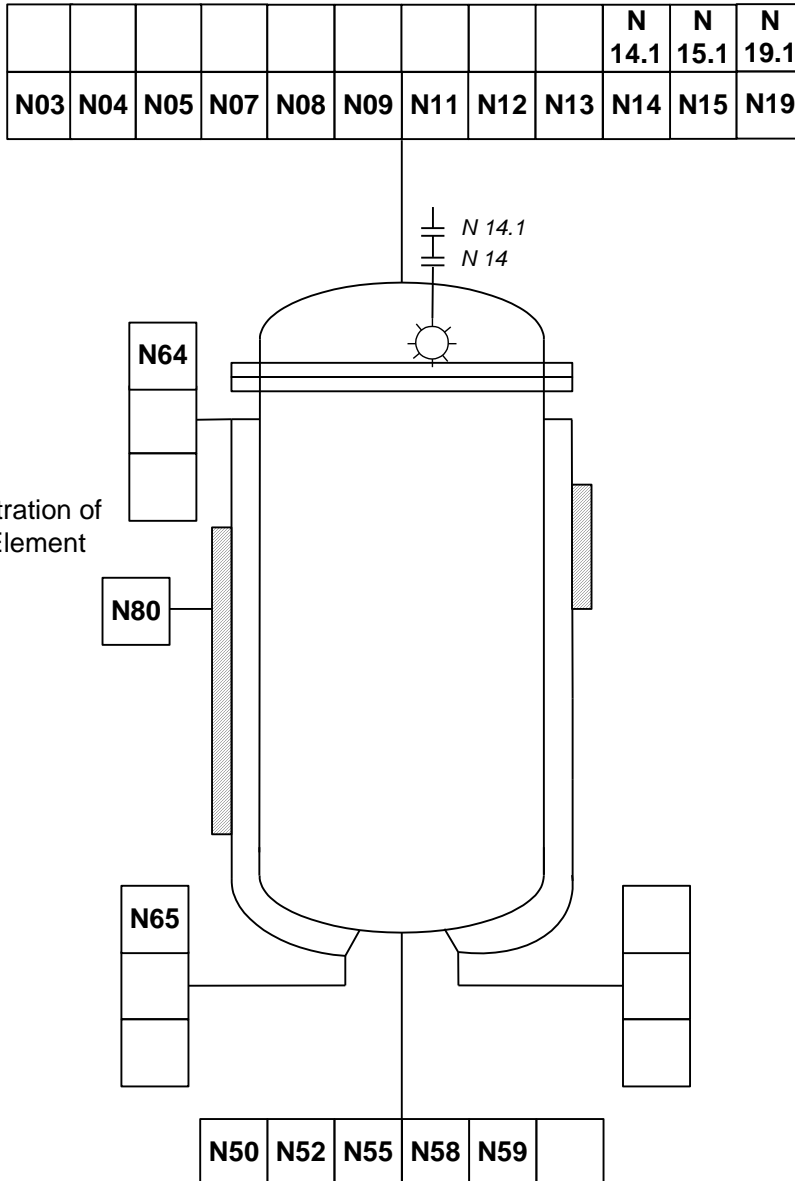

Drawing Rev. 01

Distribution of the original or copies of this document, or further use or distribution of its content is not allowed without written permission from M +W. Violators will be obligated to pay fees and penalties.

Project-No.	2304996	Data Sheet				
Code	NRCFF					
Tag-No.	1B4100					
Vessel						
PFD-No.	PVF_B_01_0060	Building-No.	B	Process	1 (rVIII-SC) / 1UB41 Buffer Hold Chroma 1	
P&ID -No.	PRI_B_01_0070	Level	10	Name	Buffer Hold Vessel 1 (C1 Wash 2)	
Drawing-No.	6722-05 001/002	Room-No.	B_10_2027	Type	Vessel	
Additional Information for Equivalent Equipment						

Tag-No.	Description	Process	PFD-No./PID-No./ Drawing-No.	Building-No./ Level/Room-No.
2B4800	Buffer Hold Vessel 25 (DF Eq+Recirc.+Filter Flush)	2 (rIX-FP) / 2UB48 Buffer Hold UF/DF 2	PVF_B_02_0069 PRI_B_02_0093 6722-05 003/004	B 10 B_10_2020
3B4550	Buffer Hold Vessel 14 (C2 Regeneration)	3 (rVIIa-FP) / 3UB45 Buffer Hold Chroma 2	PVF_B_03_0063 PRI_B_03_0083	B 10 B_10_1033